

# BLAZY PARK SUBD. Lot 22 Block 1 As-Built Survey

Located in the NW 1/4 Section 32, T5N R10W, SM,  
City of Soldotna, Kenai Peninsula Borough, Alaska.  
Kenai Recording District plat 75-43


**Prepared for**  
Deb Hunt  
Mossy Oak Properties  
511 Main St.  
Kenai, AK 99611

**Prepared by**  
Johnson Surveying  
P.O. Box 27  
Clam Gulch, Ak 99568

SCALE 1" = 40'

27 July, 2022

NOTES:  
Lot topography is flat with  
drainage to street.  
Lot is served by City Water & Sewer.  
Consult City Ordinances for setbacks  
Record plat reserved 20' building  
setback from streets.

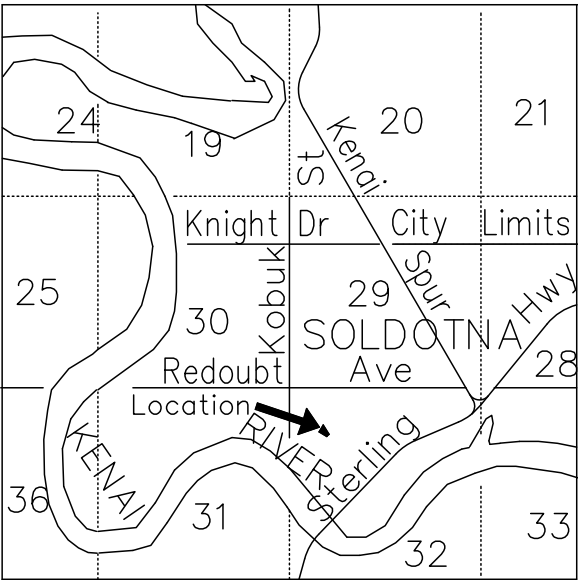

VICINITY 1" = 1 mile MAP

60' W. RIVERVIEW AVE.

