

VICINITY 1" = 1 mile MAP

Block 2-A & a portion of Block 3-A Irons Subd., Amended Lot 7 Block 3A As-Built Survey


Located in the NW 1/4 Section 29, T5N R10W, SM,
Kenai Peninsula Borough, Alaska.
Kenai Recording District plat 75-4

Prepared for
Ken Laing
35885 Glory St.
Soldotna, AK 99669

Prepared by
Johnson Surveying
P.O. Box 27
Clam Gulch, Ak 99568

SCALE 1" = 30'

23 May, 2025

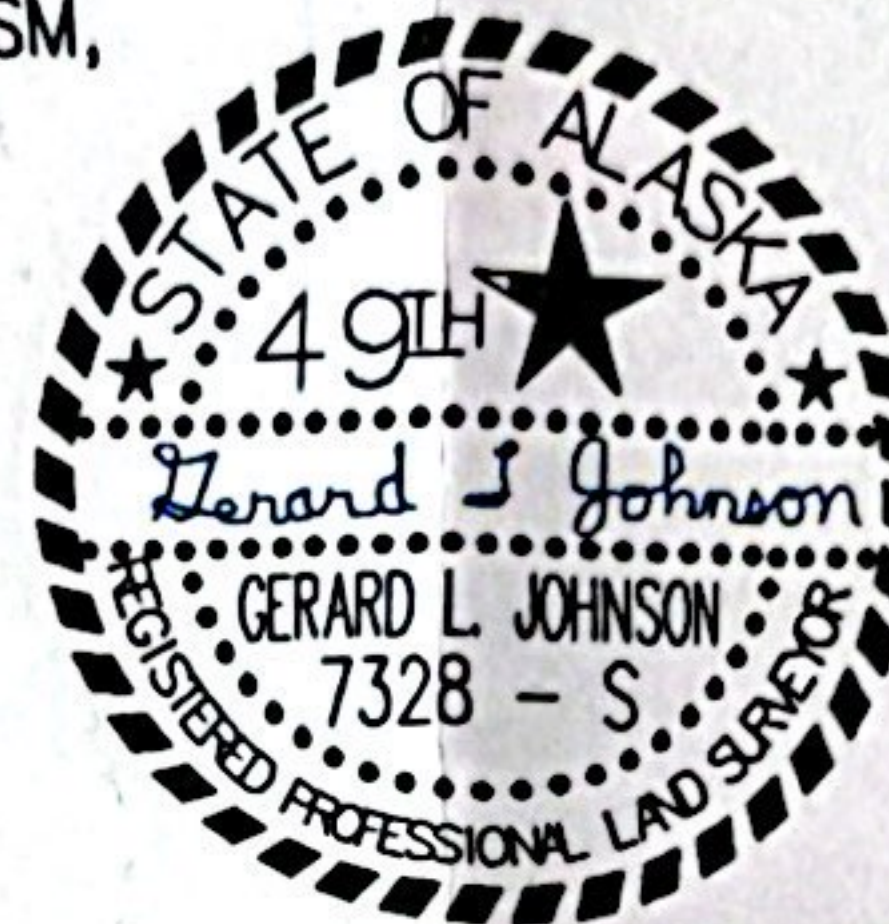

NOTES:
Lot topography is flat.

Well is 101.0' from nearest septic pipe, center to center.

