

EIDEN FARM DRAINAGE CO

35127 746th Ave - St. James, MN 56081
Office = 507 - 375 - 5774

ASBUILT TILE PROJECT


	4"	KEY
	5"	
	6"	
	7-8"	
	10"	
	12"	WHITE Assumed



MAP LOCATION

Customer


County	Martin	Spacing	75 ft
Township	Galena	D-Co eff	
Section	6d	Plan Type	Tiled 2016

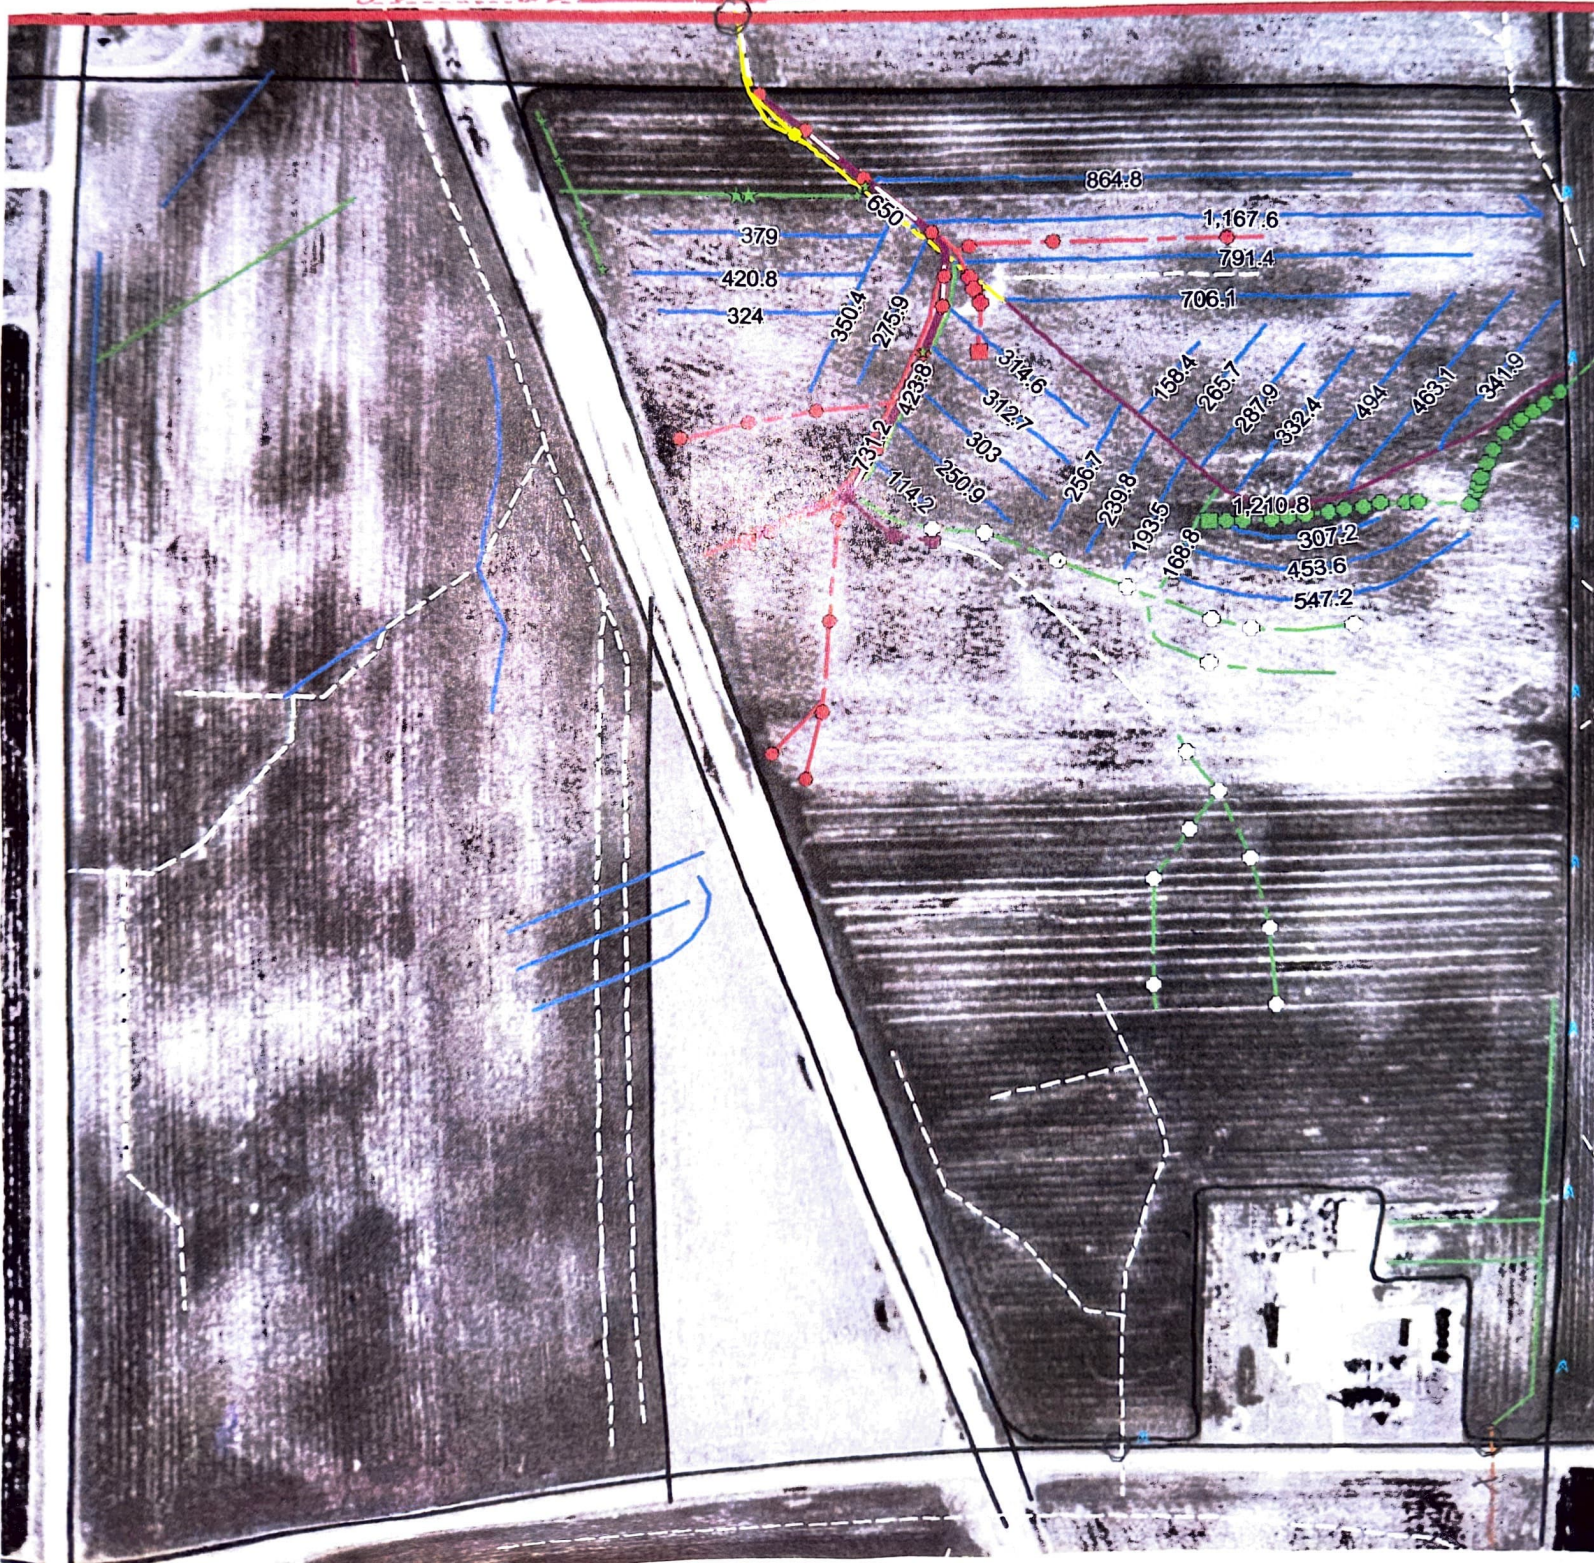


HANCOR

pacesetter in plastic drainage products

Hancor, Inc.
P. O. Box 808
Timberlake Rd.
Fairmont, Minnesota 56031
Phone (507) 238-4791

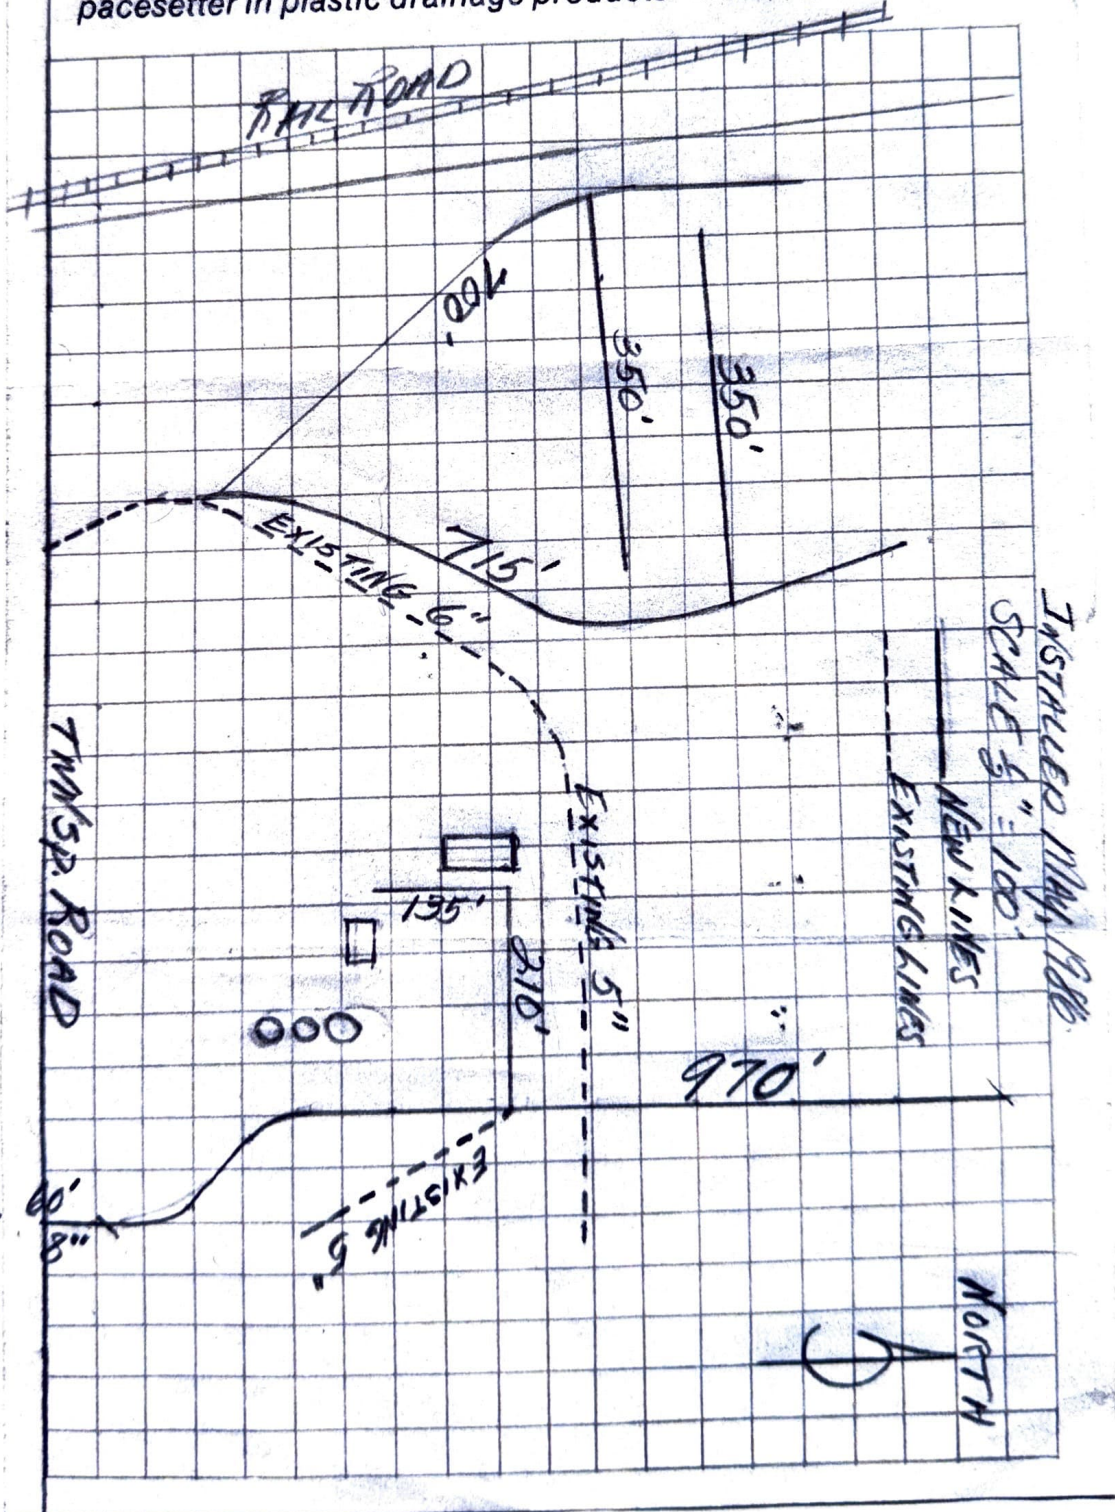

Ex 5" **HANCOR...The Best Choice™**

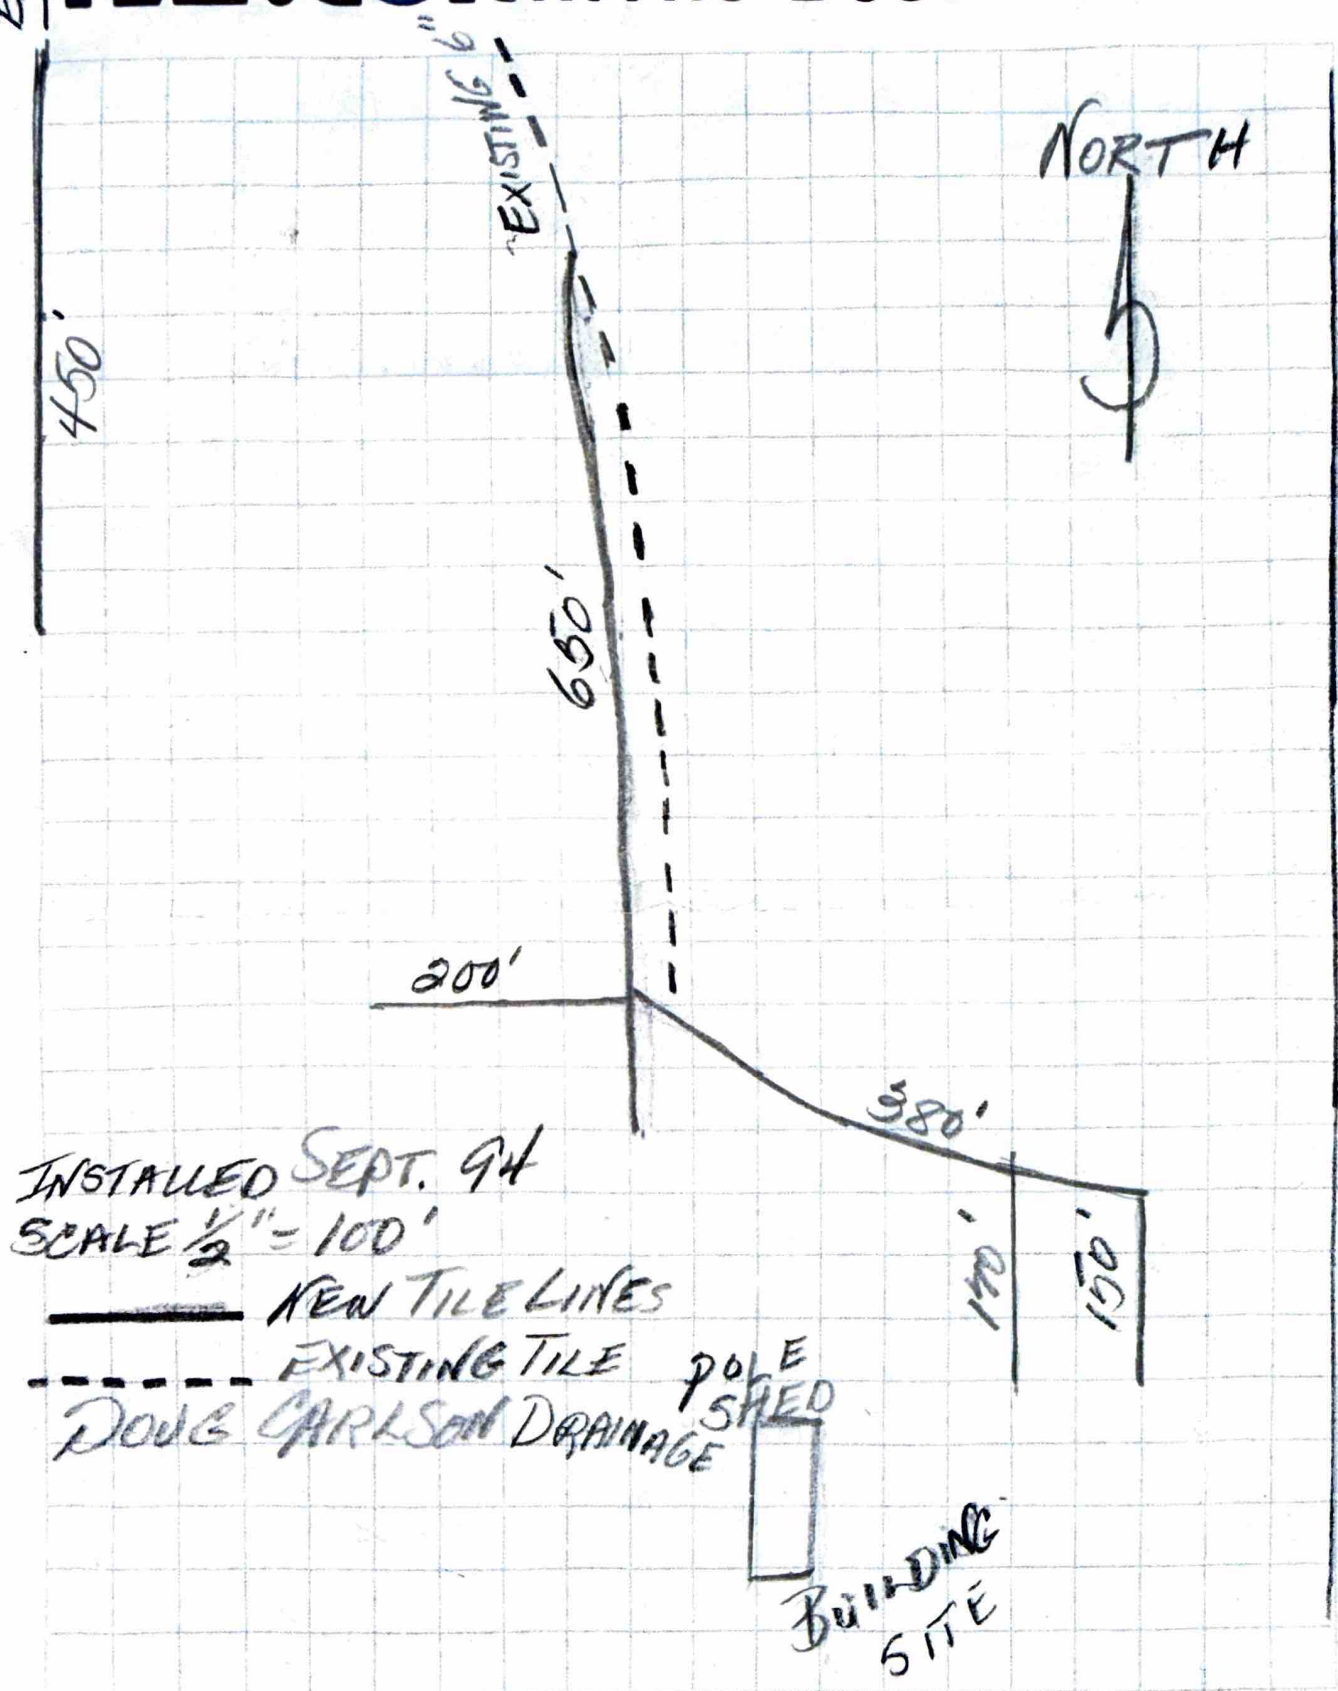

P.O. Box 808
Timberlake Rd.
Fairmont, MN 56031

Phone: 800-862-5575 (MN only)
800-533-0424 (Outside MN)
507-238-4791
Fax: 507-238-9558

... the Reservoir

R.P. March

150' 170'

TILE

560'

EXISTING
6"

NORTH

